


CLARENDON HILL APARTMENTS




REV	DATE	DESCRIPTION	DESIGNED	CHECKED	BY
1	MAR2001	AS BUILT	TM	JB	HB
2	4/18/03	Changed Level 3 reference to JTP	LM	EW	EW

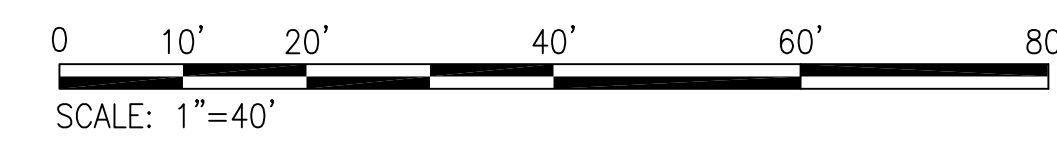

SULLIVAN & MCLAUGHLIN CO.
 74 LAWLEY STREET, BOSTON, MA 02122
 PHONE: (617) 474-0500 FAX: (617) 474 0505

CONFIDENTIAL
 FOR PROPRIETARY USE ONLY
 EXCEPT AS MAY BE OTHERWISE PROVIDED
 THIS DRAWING SHALL REMAIN THE PROPERTY OF
Level (3)
 COMMUNICATIONS
 AND SHALL NOT BE REPRODUCED, COPIED, OR USED FOR
 ANY PURPOSE WITHOUT SPECIFIC WRITTEN PERMISSION.

DRAWN BY: R. MEJIA
 CHECKED BY: J. DE BARROS
 APPROVED BY: H. BERTONI

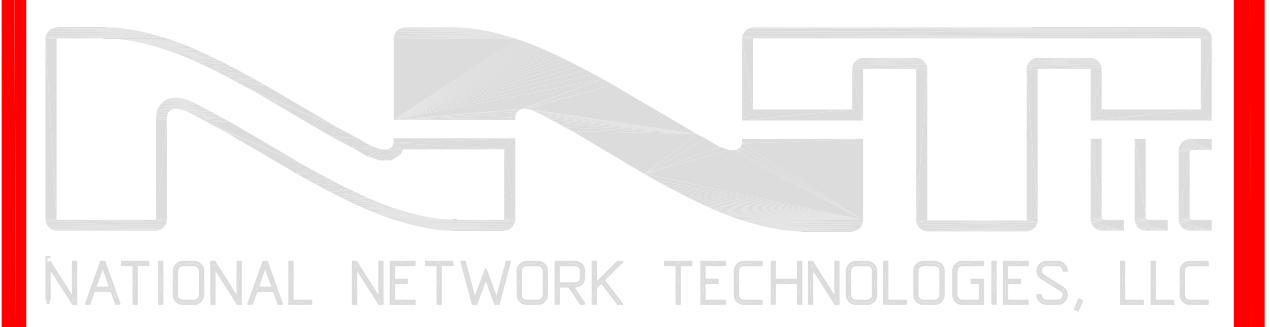

Level (3)SM
 COMMUNICATIONS

LOOP: SOMERVILLE
 SEGMENT: C-5G
 SITE ADDRESS: SOMERVILLE, MA

TITLE: BROADWAY

CONTRACT NO: 8724	SHEET: 23
DRAWING NO: SOM8724P019R1	
DATE DRAWN: APR2000	
SCALE: 1" = 40'	
PLOT DATE: 4/18/03	

SHEET: 23 OF: 24