


FOR CONTINUATION SEE SEGMENT C-5G

MATCHLINE STATION 05+27
SEE DWG SOM8725P002R1



REV	DATE	DESCRIPTION	DESIGNED	CHECKED	BY
1	MAR2001		LS	JB	HJD
2	4/15/03	Changed Level 3 reference to JTP	LM	BW	BW

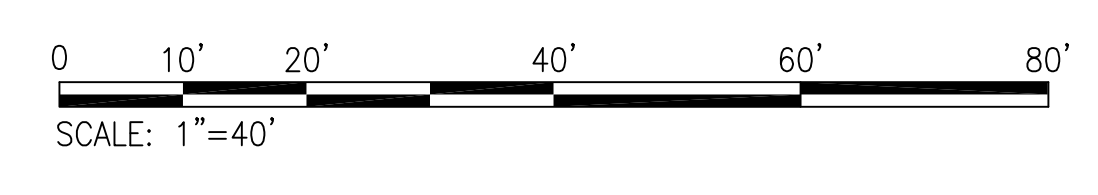

SULLIVAN & MCLAUGHLIN CO.
74 LAWLEY STREET, BOSTON, MA 02122
PHONE: (617) 474-0500 FAX: (617) 474 0505

CONFIDENTIAL
FOR PROPRIETARY USE ONLY
EXCEPT AS MAY BE OTHERWISE PROVIDED
THIS DRAWING SHALL REMAIN THE PROPERTY OF
Level (3)
COMMUNICATIONS
AND SHALL NOT BE REPRODUCED, COPIED, OR USED FOR
ANY PURPOSE WITHOUT SPECIFIC WRITTEN PERMISSION.

DRAWN BY: L. SCOTTO
CHECKED BY: J. DE BARROS
APPROVED BY: H. BERTONI



Level (3)SM
COMMUNICATIONS

LOOP: SOMERVILLE
SEGMENT: C-5E
SITE ADDRESS: SOMERVILLE, MA

TITLE: SACRAMENTO ST.

CONTRACT NO: 8725
DRAWING NO: SOM8725P001R1
DATE DRAWN: NOV2000
SCALE: 1" = 40'
PLOT DATE: 4/15/03

SHEET: 5 OF: 12

05