


BURIED WITH MIN 30"  
OF COVER UNLESS  
OTHERWISE SPECIFIED

JTP (64)-1 1/2" HDPE  
(7) 4" PVC DUCTS

188' LF c/c

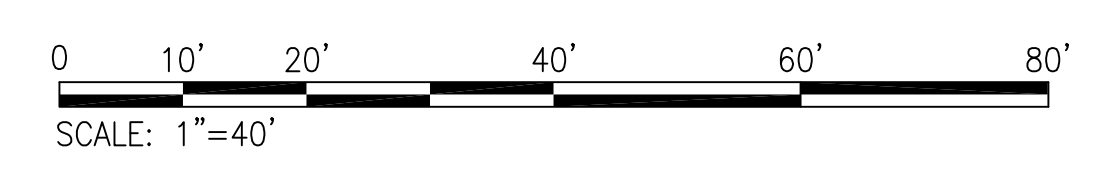

REV	DATE	DESCRIPTION	DESIGNED	CHECKED	BY
1	MAR2001		LS	JB	HIC
2	4/15/03	Changed Level 3 reference to JTP	LM	BW	BR



**SULLIVAN & MCLAUGHLIN CO.**  
74 LAWLEY STREET, BOSTON, MA 02122  
PHONE: (617) 474-0500 FAX: (617) 474 0505

**CONFIDENTIAL**  
FOR PROPRIETARY USE ONLY  
EXCEPT AS MAY BE OTHERWISE PROVIDED  
THIS DRAWING SHALL REMAIN THE PROPERTY OF  
**Level (3)**  
COMMUNICATIONS  
AND SHALL NOT BE REPRODUCED, COPIED, OR USED FOR  
ANY PURPOSE WITHOUT SPECIFIC WRITTEN PERMISSION.

DRAWN BY: L. SCOTTO  
CHECKED BY: J. DE BARROS  
APPROVED BY: H. BERTONI



**Level (3)**<sup>SM</sup>  
COMMUNICATIONS

LOOP: SOMERVILLE  
SEGMENT: C-5E  
SITE ADDRESS: SOMERVILLE, MA  
TITLE: SACRAMENTO ST.

CONTRACT NO: 8725  
DRAWING NO: SOM8725P002R1  
DATE DRAWN: NOV2000  
SCALE: 1" = 40'  
PLOT DATE: 4/15/03

SHEET: 6 OF 12

06