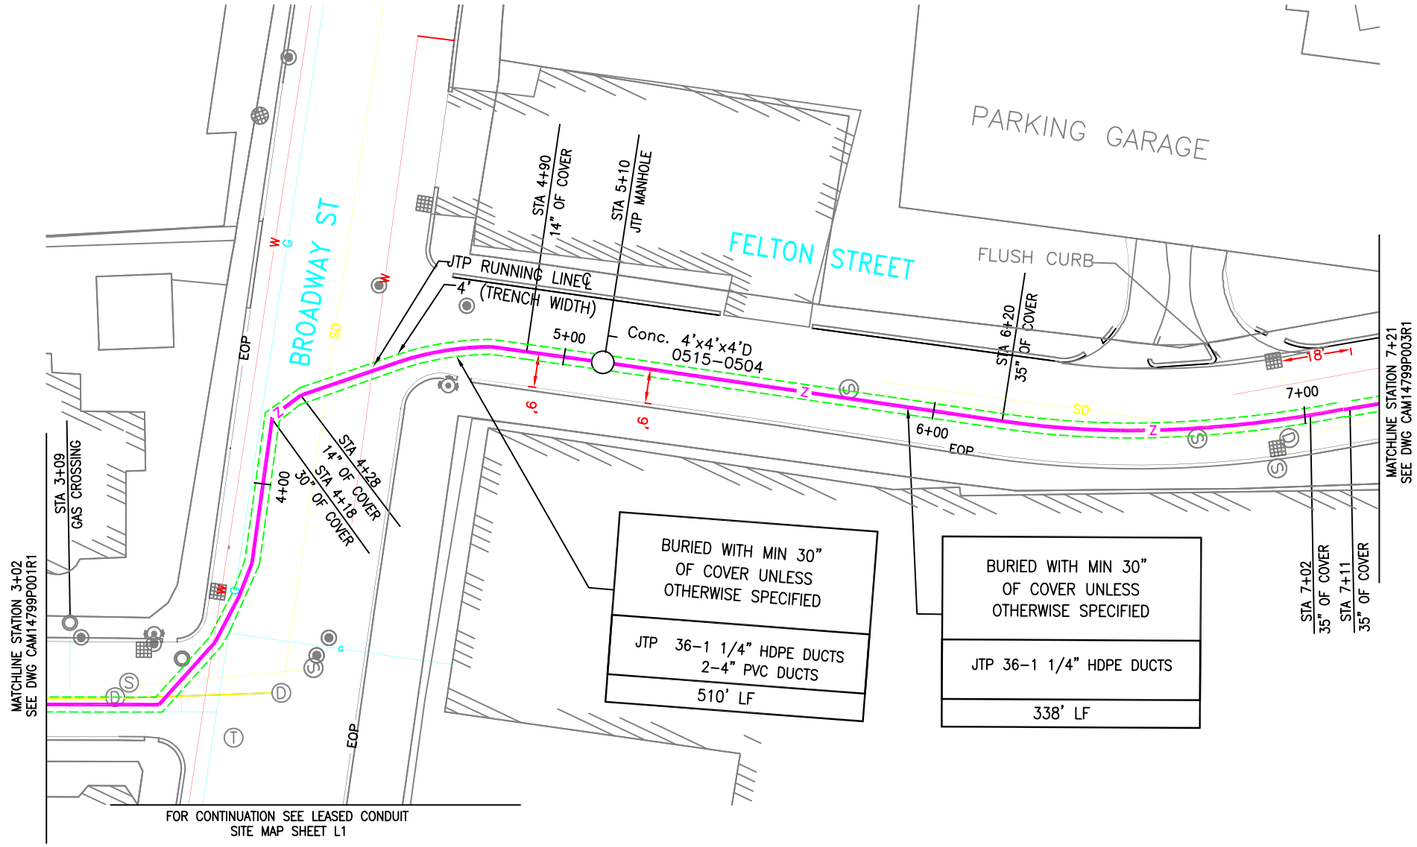

0 10' 20' 40' 60' 80'
SCALE: 1"=40'

REV	DATE	DESCRIPTION	DESIGNER	CHECKED	APPROVED
1	MAR2002	AS-BUILT	RM	MS	ES
2	4/16/03	Changed Level 3 reference to JTP	LM	BW	BW

SULLIVAN & McLAUGHLIN CO.
74 LAWLEY STREET, BOSTON, MA 02122
PHONE: (617) 474-0500 FAX: (617) 474 0505

CONFIDENTIAL
FOR PROPRIETARY USE ONLY
EXCEPT AS MAY BE OTHERWISE PROVIDED
THIS DRAWING SHALL REMAIN THE PROPERTY OF
Level(3) COMMUNICATIONS
AND SHALL NOT BE REPRODUCED, COPIED, OR USED FOR ANY PURPOSE WITHOUT SPECIFIC WRITTEN PERMISSION.

DRAWN BY: RM
CHECKED BY: MS
APPROVED BY: ES

NATIONAL NETWORK TECHNOLOGIES, LLC

Level(3) COMMUNICATIONS

LOOP: B LOOP
SEGMENT: B-1A;B-1B;B-1C;B-1D;B-2;B-3 B-4;B-5;B-6B;B-6;B-6A;B-7;B-8;A-1
SITE ADDRESS: FELTON ST CAMBRIDGE, MA
TITLE: AS-BUILT PLAN
CONTRACT NO: 14799
DRAWING NO: CAM14799P002R1
DATE DRAWN: MARCH2002
SCALE: 1" = 40'
PLOT DATE: 4/16/03
SHEET: 06
SHEET: 6 OF: 37