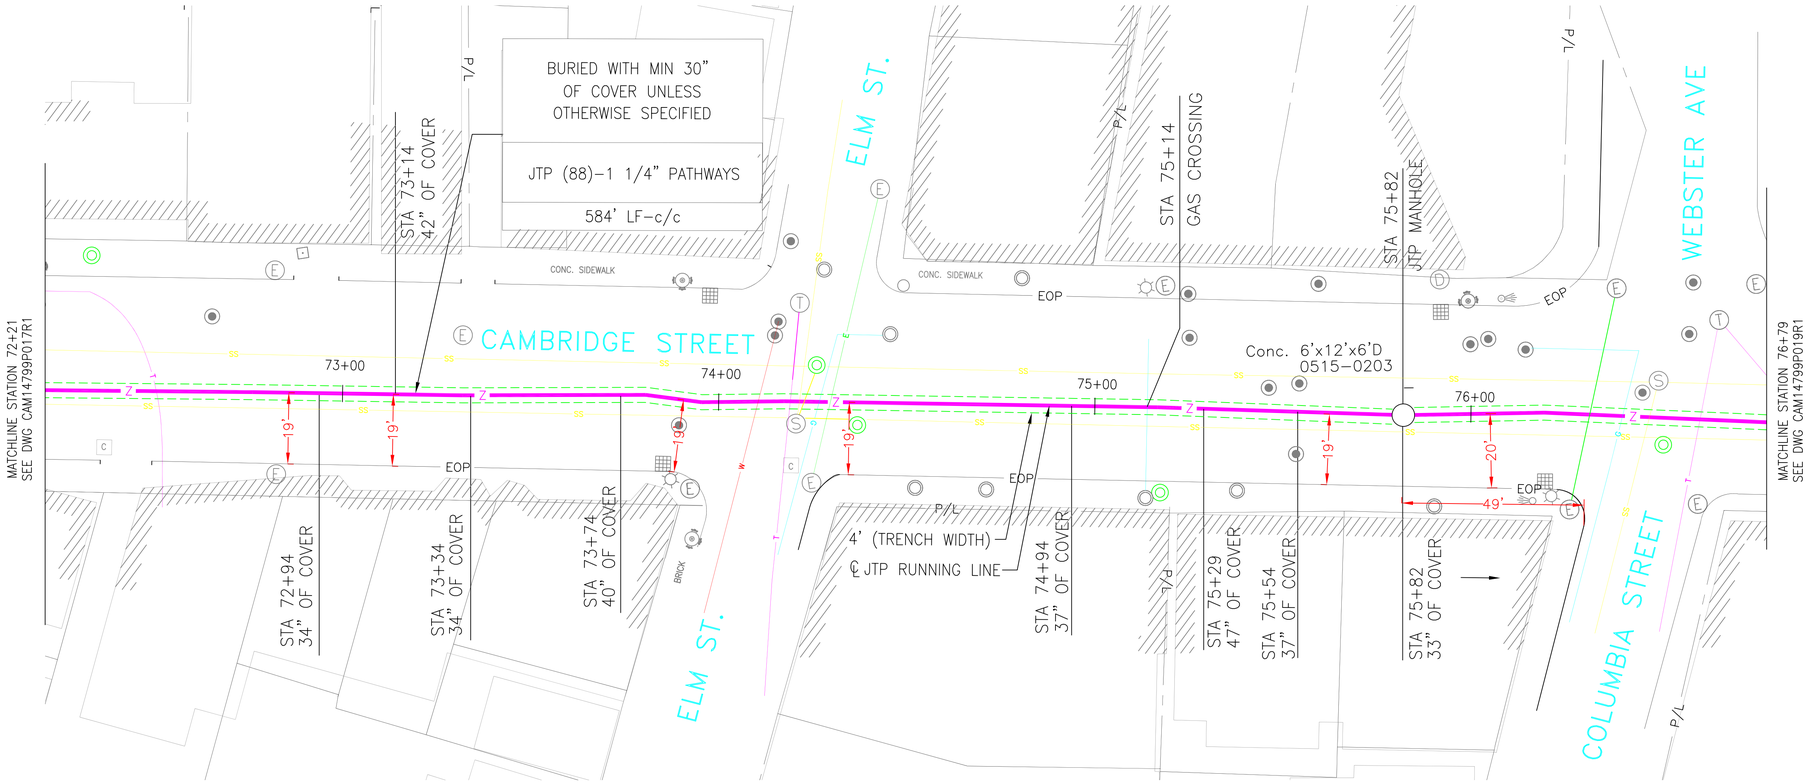

REV	DATE	DESCRIPTION	DESIGNED	CHECKED	APPROVED
1	MAR2002	AS-BUILT	RM	MS	ES
2	4/16/03	Changed Level 3 reference to JTP	LM	BW	BW

SULLIVAN & McLAUGHLIN CO.

74 LAWLEY STREET, BOSTON, MA 02122
PHONE: (617) 474-0500 FAX: (617) 474 0505

CONFIDENTIAL
FOR PROPRIETARY USE ONLY
EXCEPT AS MAY BE OTHERWISE PROVIDED THIS DRAWING SHALL REMAIN THE PROPERTY OF Level (3) COMMUNICATIONS AND SHALL NOT BE REPRODUCED, COPIED, OR USED FOR ANY PURPOSE WITHOUT SPECIFIC WRITTEN PERMISSION.

DRAWN BY: RM

CHECKED BY: MS

APPROVED BY: ES

NATIONAL NETWORK TECHNOLOGIES, LLC

Level (3) COMMUNICATIONS

LOOP: B LOOP

SEGMENT: B-1A;B-1B;B-1C;B-1D;B-2;B-3 B-4;B-5;B-6B;B-6;B-6A;B-7;B-8;A-1

SITE ADDRESS: CAMBRIDGE ST CAMBRIDGE, MA

TITLE: AS-BUILT PLAN

CONTRACT NO: 14799

DRAWING NO: CAM14799P018R1

DATE DRAWN: MARCH2002

SCALE: 1" = 40'

PLOT DATE: 4/16/03

SHEET: 22

SHEET: 22 OF: 37