REV	DATE	DESCRIPTION	DESIGN	CHECK	APPROV
1	MAR2001	AS BUILT	RM	JB	HB
2	4/16/03	Changed Level 3 reference to JTP	LM	BW	BW

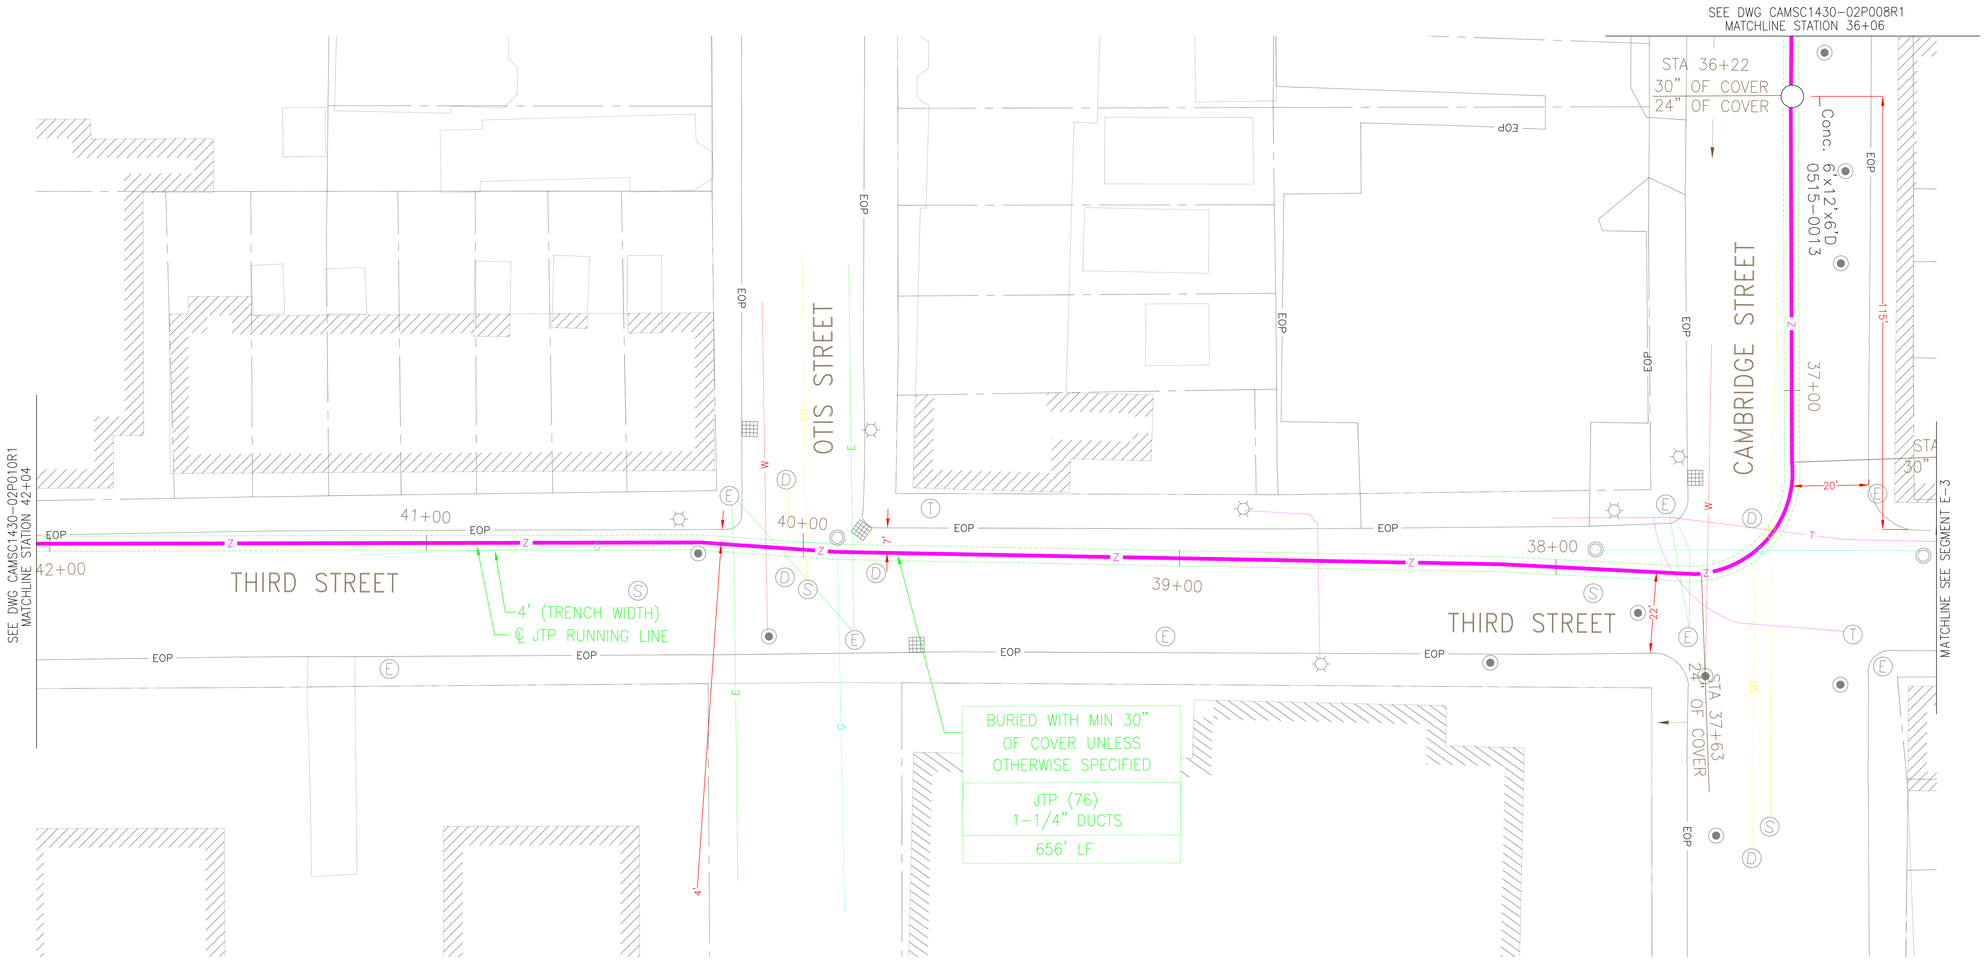

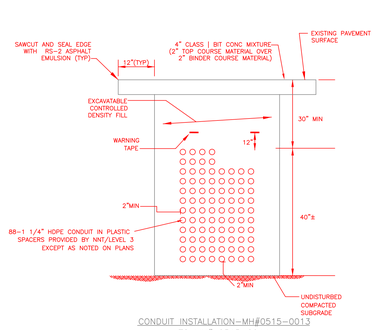

CONDUIT INSTALLATION-MH#0515-0013
TO MH# 0515-0014
N.T.S.

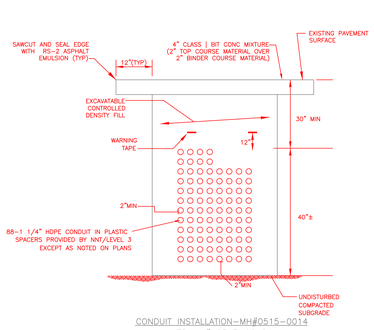

CONDUIT INSTALLATION-MH#0515-0014
TO MH# 0515-0012
N.T.S.

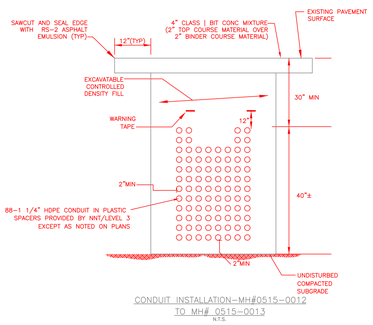

CONDUIT INSTALLATION-MH#0515-0012
TO MH# 0515-0013
N.T.S.

0 10' 20' 40' 60' 80'
SCALE: 1"=40'

SULLIVAN & McLAUGHLIN CO.
74 LAWLEY STREET, BOSTON, MA 02122
PHONE: (617) 474-0500 FAX: (617) 474 0505

CONFIDENTIAL
FOR PROPRIETARY USE ONLY
EXCEPT AS MAY BE OTHERWISE PROVIDED
THIS DRAWING SHALL REMAIN THE PROPERTY OF
Level (3) COMMUNICATIONS
AND SHALL NOT BE REPRODUCED, COPIED, OR USED FOR ANY PURPOSE WITHOUT SPECIFIC WRITTEN PERMISSION.

DRAWN BY: R. MEJIA
CHECKED BY: J. DEBARROS
APPROVED BY: H. BERTONI

NATIONAL NETWORK TECHNOLOGIES, LLC

Level (3) SM COMMUNICATIONS

LOOP: CAMBRIDGE
SEGMENT: B-1 LOOP
SITE ADDRESS: CAMBRIDGE, MA
TITLE: THIRD ST

CONTRACT NO: SC1430-02
DRAWING NO: CAMSC1430-02P009R1
DATE DRAWN: APR2000
SCALE: 1"=40'
PLOT DATE: 4/16/03

SHEET: 13
SHEET: 13 OF: 19