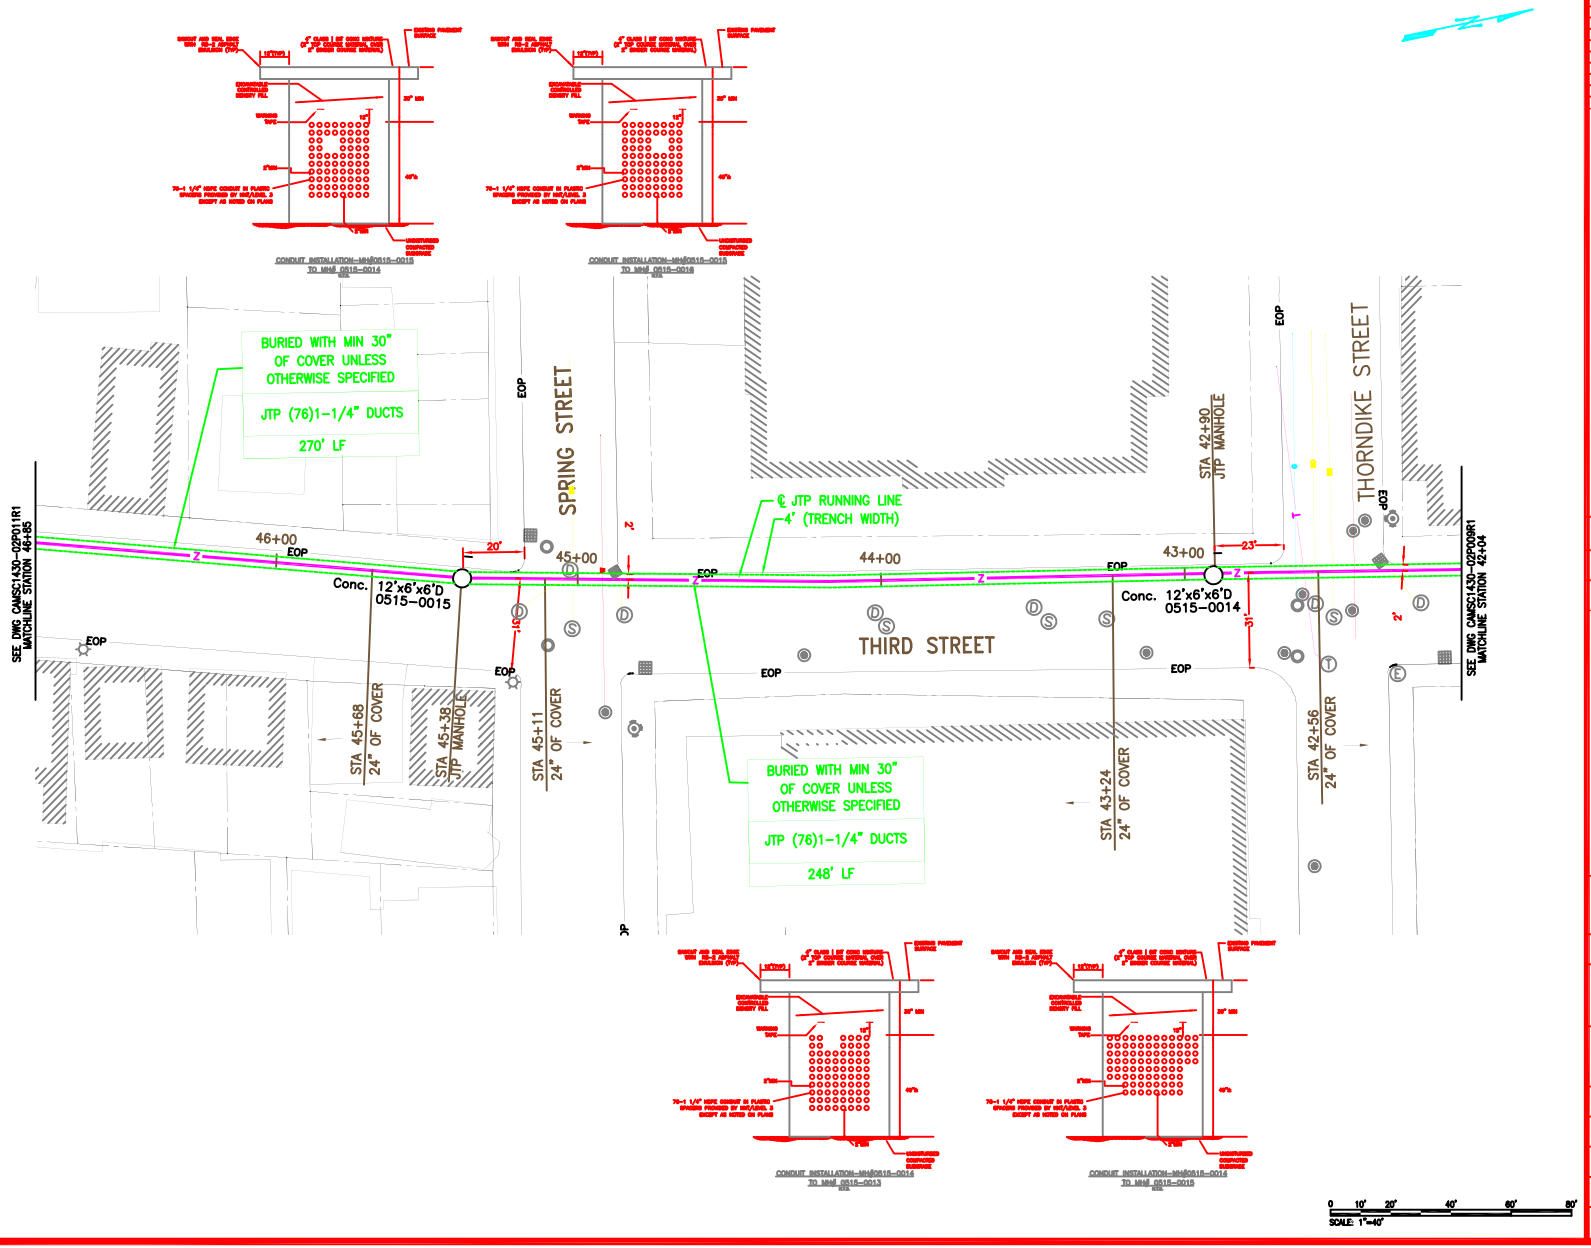

REV	DATE	DESCRIPTION	BDRM	CHECKED	APPRD
1	MAR2001	AS BUILT	RM	JB	HB
2	07/09/03	Changed Level 3 reference to JTP	LM	BW	BB

SULLIVAN & McLAUGHLIN CO

74 LAWLEY STREET, BOSTON, MA 02122
PHONE: (617) 474-0500 FAX: (617) 474 0505

CONFIDENTIAL
FOR PROPRIETARY USE ONLY
EXCEPT AS MAY BE OTHERWISE PROVIDED THIS DRAWING SHALL REMAIN THE PROPERTY OF Level(3) COMMUNICATIONS AND SHALL NOT BE REPRODUCED, COPIED, OR USED FOR ANY PURPOSE WITHOUT SPECIFIC WRITTEN PERMISSION.

DRAWN BY: R. MEJIA
CHECKED BY: J. DEBARROS
APPROVED BY: H. BERTONI

NATIONAL NETWORK TECHNOLOGIES, LLC

LOOP: CAMBRIDGE
SEGMENT: B-1 LOOP
SITE ADDRESS: CAMBRIDGE, MA
TITLE: THIRD ST

CONTRACT NO: SC1430-02
DRAWING NO: CAMSC1430-02P010R1
DATE DRAWN: APR2000
SCALE: 1"=40'
PLOT DATE: MAR 28, 2001 10:00

SHEET: 14
SHEET:14 OF: 19