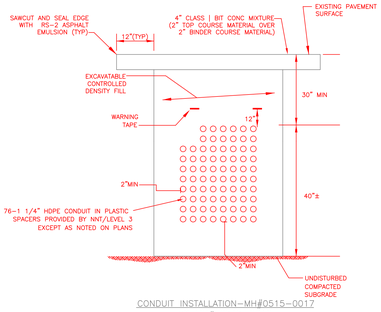

CONDUIT INSTALLATION–MH#0515–0017
TO MH# 0515–0016
N.T.S.

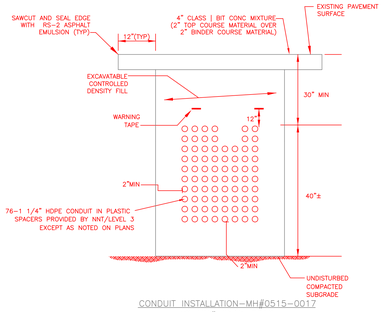

CONDUIT INSTALLATION–MH#0515–0017
TO MH# 0515–0018
N.T.S.

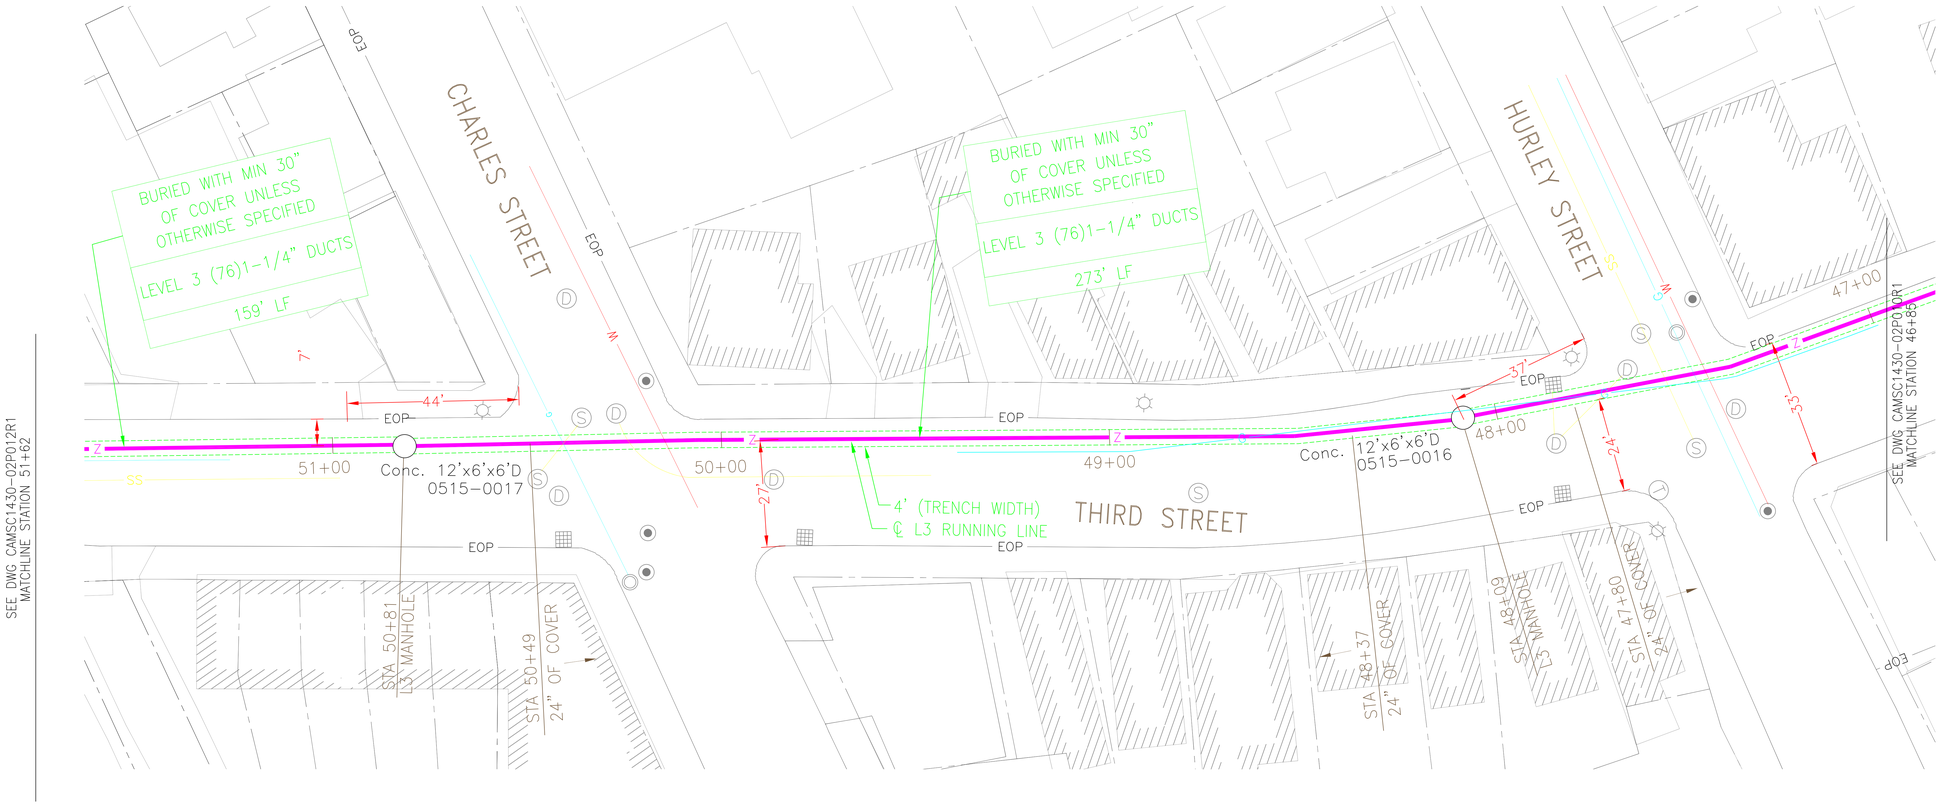

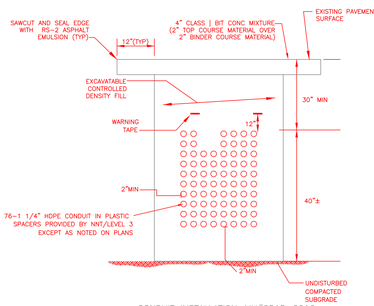

CONDUIT INSTALLATION–MH#0515–0016
TO MH# 0515–0015
N.T.S.

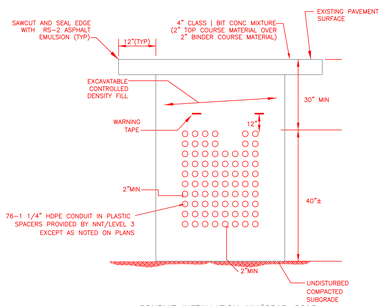

CONDUIT INSTALLATION–MH#0515–0016
TO MH# 0515–0017
N.T.S.

0 10' 20' 40' 60' 80'
SCALE: 1"=40'

REV.	DATE	DESCRIPTION	DESIGNED	CHECKED	APPVMD
1	MAR2001	AS BUILT	RM	JB	HB
2	07/17/03	Changed Level 3 reference to JTP	LM	BW	BW

SULLIVAN & McLAUGHLIN CO.
74 LAWLEY STREET, BOSTON, MA 02122
PHONE: (617) 474–0500 FAX: (617) 474 0505

CONFIDENTIAL
FOR PROPRIETARY USE ONLY
EXCEPT AS MAY BE OTHERWISE PROVIDED
THIS DRAWING SHALL REMAIN THE PROPERTY OF
Level (3) COMMUNICATIONS
AND SHALL NOT BE REPRODUCED, COPIED, OR USED FOR ANY PURPOSE WITHOUT SPECIFIC WRITTEN PERMISSION.

DRAWN BY: R. MEJIA
CHECKED BY: J. DEBARROS
APPROVED BY: H. BERTONI

NATIONAL NETWORK TECHNOLOGIES, LLC

LOOP: CAMBRIDGE
SEGMENT: B–1 LOOP
SITE ADDRESS: CAMBRIDGE, MA
TITLE: THIRD ST
CONTRACT NO: SC1430–02
DRAWING NO: CAMSC1430–02P011R1
DATE DRAWN: APR2000
SCALE: 1"=40'
PLOT DATE: MAR 28, 2001 10:00
SHEET:
15
SHEET: 15 OF: 19