
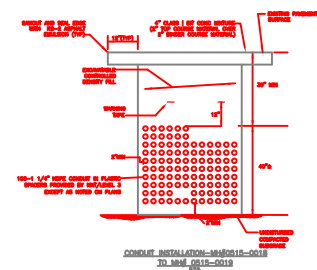


SEE DWG CAMS1430-02P01R1
MATCHLINE STATION 51+82

SEE DWG CAMS1430-02P01R1
MATCHLINE STATION 51+82

MATCHLINE SEE SEGMENT A-2

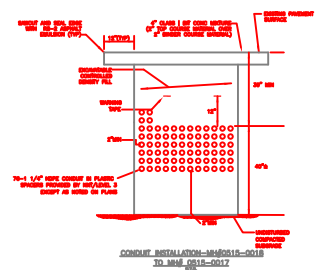

0 10' 20' 40' 60' 80'
SCALE: 1"=40'

REV	DATE	DESCRIPTION	BY	CHKD	APPD
1	MR2001	AS EBLT	RM	BL	
2	07/17/03	Changed Level 3 reference to JTP	LM	BL	



SULLIVAN & McLAUGHLIN CO
74 LAWLEY STREET, BOSTON, MA 02122
PHONE: (617) 474-0500 FAX: (617) 474-0505

CONFIDENTIAL
FOR PROPRIETARY USE ONLY
EXCEPT AS MAY BE OTHERWISE PROVIDED
THIS DRAWING SHALL REMAIN THE PROPERTY OF
Level(3)
AND SHALL NOT BE REPRODUCED, COPIED, OR USED FOR
ANY PURPOSE WITHOUT SPECIFIC WRITTEN PERMISSION.

DRAWN BY: R. MEJIA
CHECKED BY: J. DEBARROS
APPROVED BY: H. BERTONI



LOOP: CAMBRIDGE
SEGMENT: B-1 LOOP
SITE ADDRESS: CAMBRIDGE, MA
TITLE: BENT & THIRD ST

CONTRACT NO: SC1430-02
DRAWING NO: CAMS1430-02P012R1
DATE DRAWN: APR2000
SCALE: 1"=40'
PLOT DATE: MAR 28, 2001 10:00

SHEET:
16
SHEETS: 15 OF 19