REV	DATE	DESCRIPTION	DESIGNER	CHECKED	APPROVED
1	FEB2001	AS BUILT	RM	JB	HB
2	4/18/03	Changed Level 3 reference to JTP	LM	BW	BW

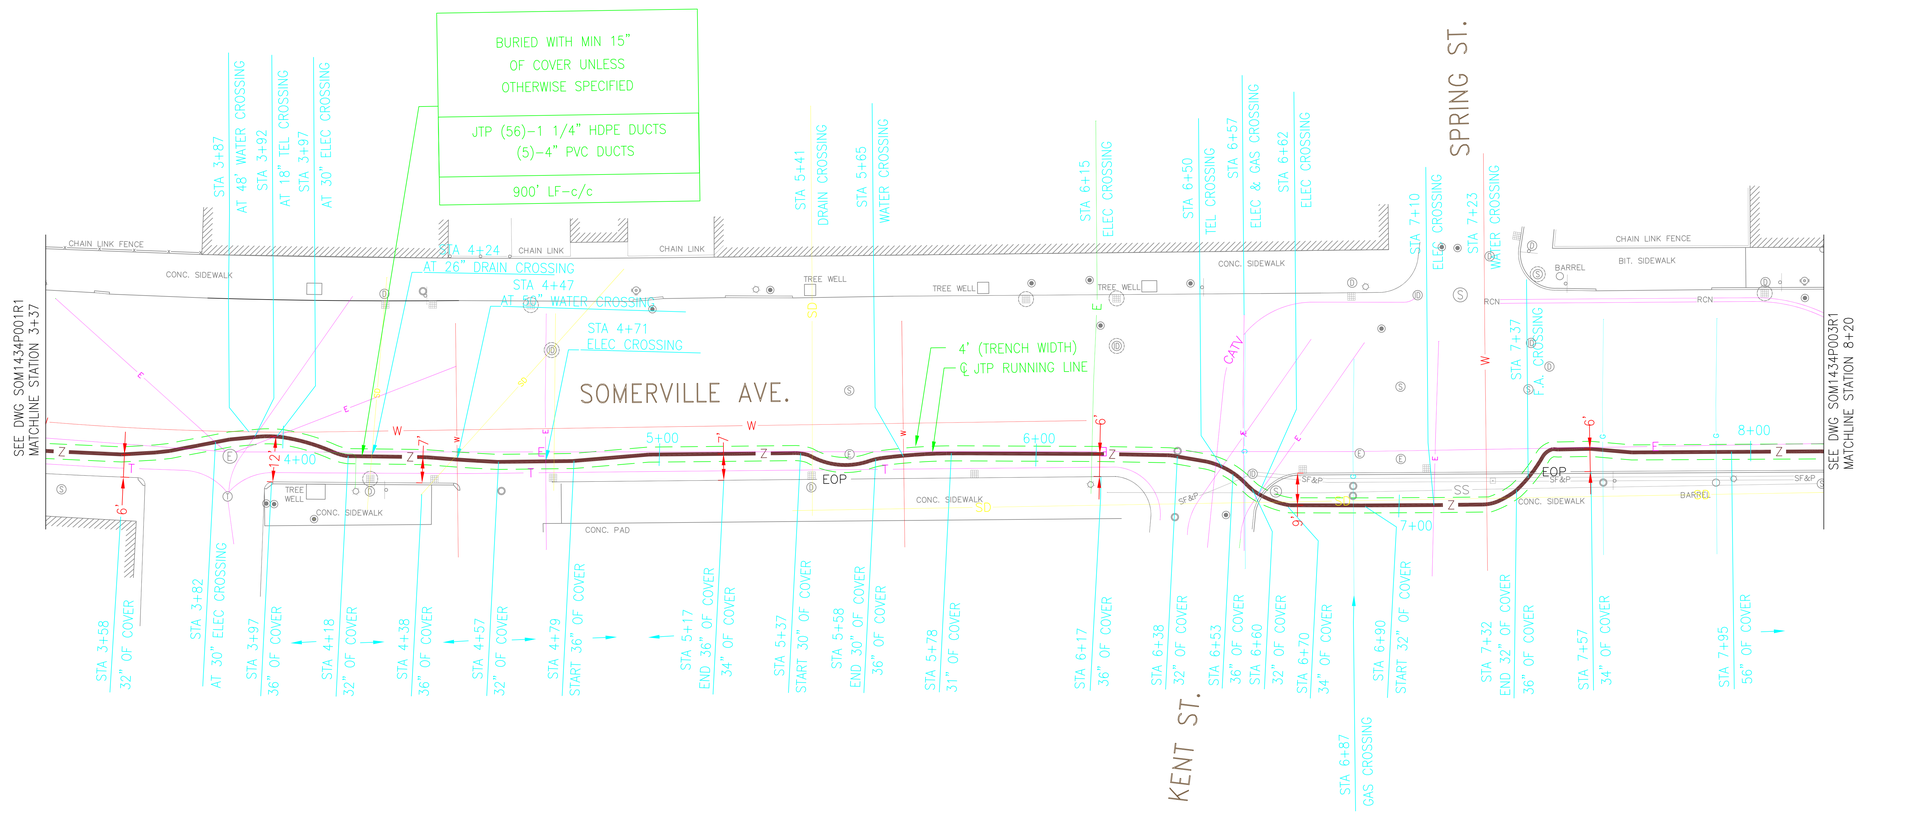

SULLIVAN & McLAUGHLIN CO.
74 LAWLEY STREET, BOSTON, MA 02122
PHONE: (617) 474-0500 FAX: (617) 474 0505

CONFIDENTIAL
FOR PROPRIETARY USE ONLY
EXCEPT AS MAY BE OTHERWISE PROVIDED THIS DRAWING SHALL REMAIN THE PROPERTY OF Level (3) COMMUNICATIONS AND SHALL NOT BE REPRODUCED, COPIED, OR USED FOR ANY PURPOSE WITHOUT SPECIFIC WRITTEN PERMISSION.

DRAWN BY: R. MEJIA
CHECKED BY: J. DEBARROS
APPROVED BY: H. BERTONI

NATIONAL NETWORK TECHNOLOGIES, LLC

Level (3) COMMUNICATIONS

LOOP: SOMERVILLE
SEGMENT: E-1
SITE ADDRESS: SOMERVILLE, MA
TITLE: SOMERVILLE AVENUE

CONTRACT NO: 1434
DRAWING NO: SOM1434P002R1
DATE DRAWN: FEB2001
SCALE: 1" = 40'
PLOT DATE: 4/18/03

SHEET: 06
SHEET: 6 OF: 8