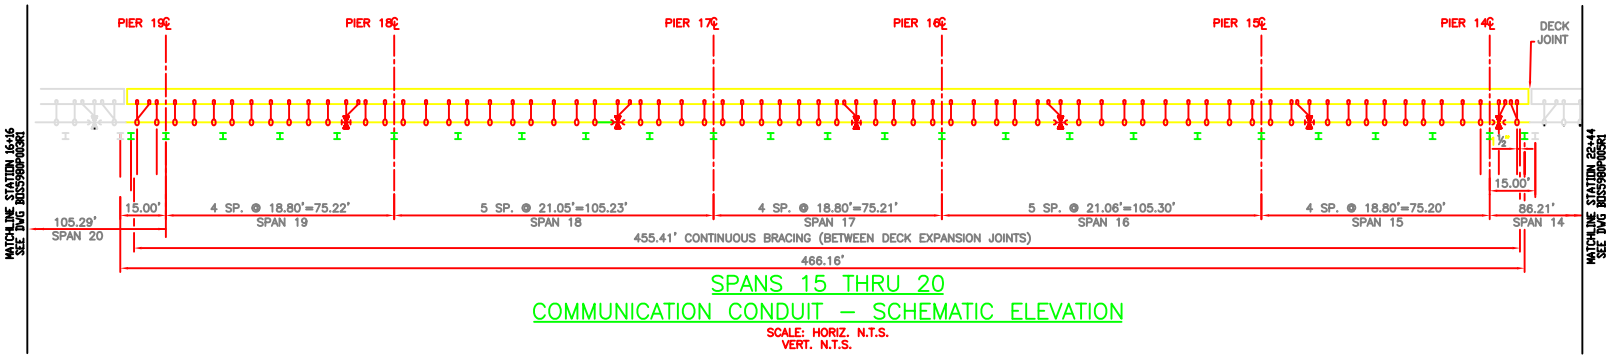

SPANS 15 THRU 20
COMMUNICATION CONDUIT – SCHEMATIC ELEVATION

SCALE: HORIZ. N.T.S.
VERT. N.T.S.

LEGEND

- ANCHOR SUPPORT WITH EXPANSION JOINT AND BRACING
- ANCHOR SUPPORT – FIXED WITH BRACING
- INTERMEDIATE SUPPORT WITH BRACING AT DECK JOINT ONLY
- INTERMEDIATE SUPPORT WITHOUT BRACING

NOTE

SCHEMATIC ELEVATION SHOWS PROPOSED CONDITIONS ON THE WEST SIDE OF THE BRIDGE.

REV	DATE	DESCRIPTION	DRAWN	CHECKED	APPROVED
1	MAR2001	AS BUILT	LS	JB	HB
2	2/17/04	Changed Level 3 reference to JTP	LM	BW	BW

SULLIVAN & McLAUGHLIN CO.
74 LAWLEY STREET, BOSTON, MA 02122
PHONE: (617) 474-0500 FAX: (617) 474 0505

CONFIDENTIAL
FOR PROPRIETARY USE ONLY
EXCEPT AS MAY BE OTHERWISE PROVIDED THIS DRAWING SHALL REMAIN THE PROPERTY OF Level(3) COMMUNICATIONS AND SHALL NOT BE REPRODUCED, COPIED, OR USED FOR ANY PURPOSE WITHOUT SPECIFIC WRITTEN PERMISSION.

DRAWN BY: L. SCOTTO
CHECKED BY: J. DEBARROS
APPROVED BY: H. BERTONI

NATIONAL NETWORK TECHNOLOGIES, LLC
65 BAY STATE DRIVE, BRAINTREE, MA 02184
PHONE: (781) 849-3900 FAX: (781) 849-3993

Level(3) COMMUNICATIONS

LOOP: BOSTON
SEGMENT: A-13
SITE ADDRESS: BOSTON, MA

TITLE: HARVARD BRIDGE

CONTRACT NO: 5980
DRAWING NO: BOS5980P002R1
DATE DRAWN: SEPT2000
SCALE: N.T.S.
PLOT DATE: FEB 17, 2004 10:00

SHEET: 09
SHEET: 09 OF: 17