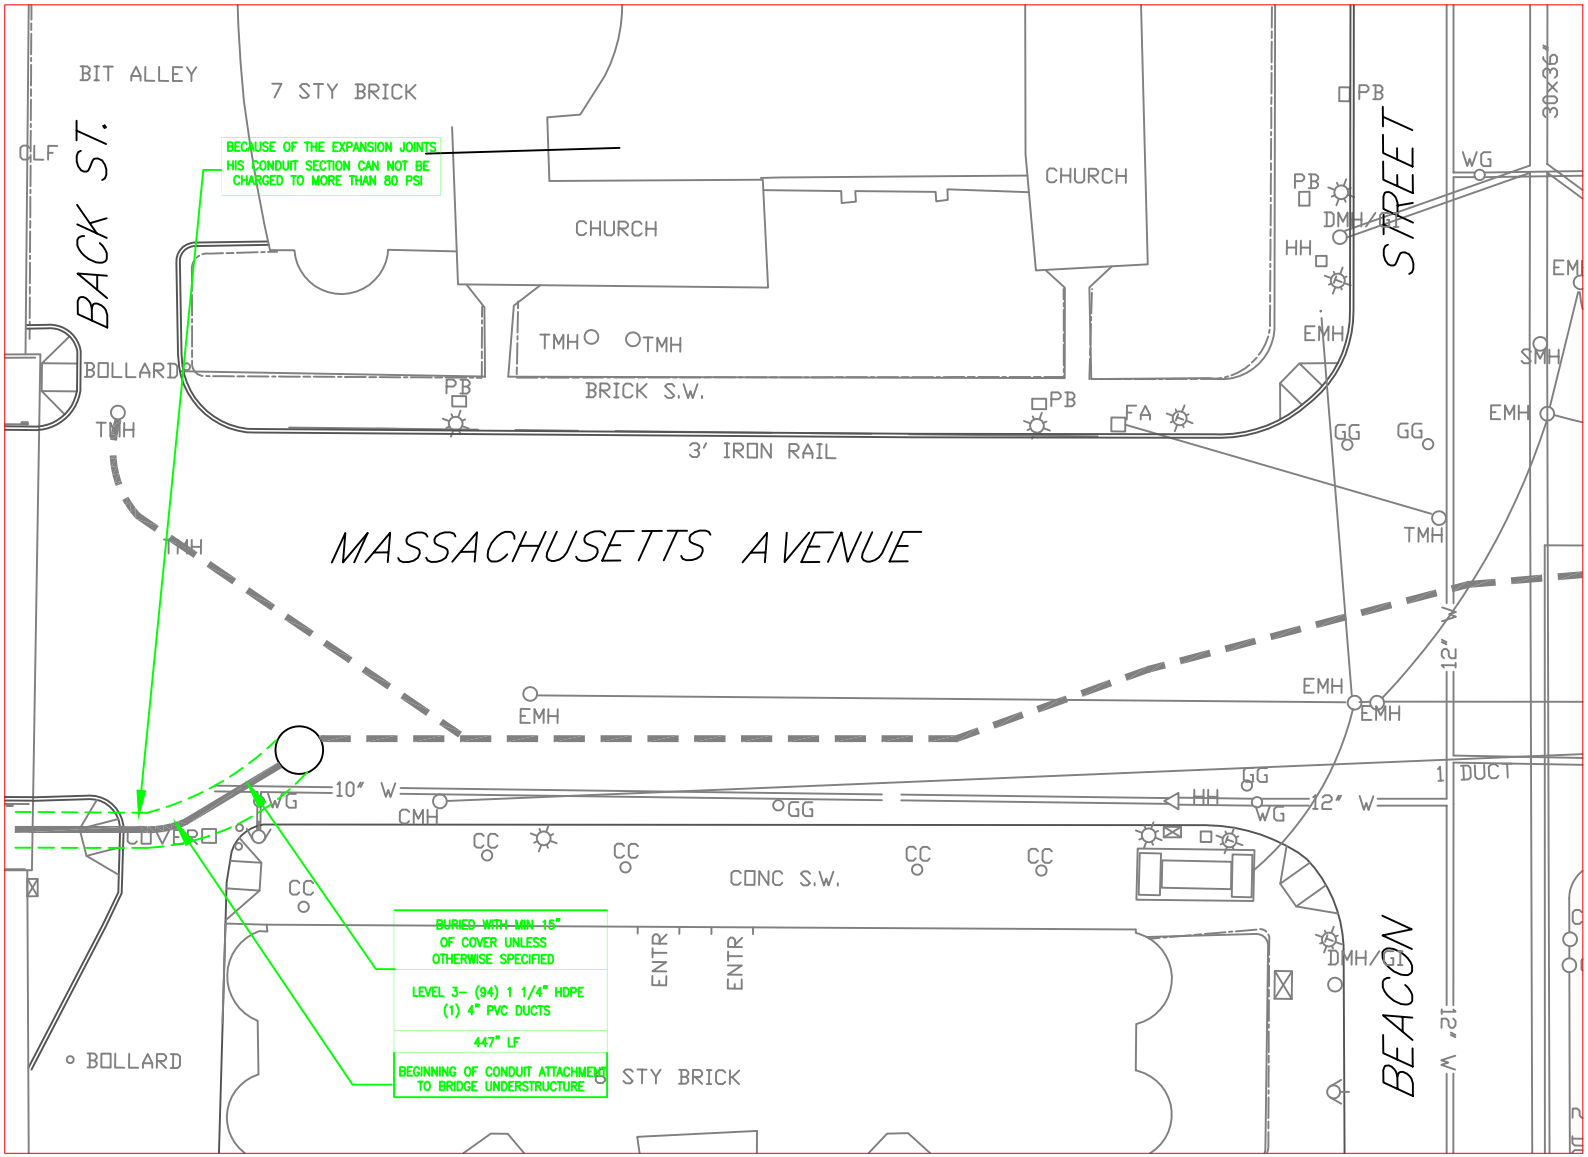

REV	DATE	DESCRIPTION	DRAWN	CHECKED	APPROVED
1	MAR2001	AS BUILT	LS	JB	HB
2	2/17/04	Changed Level 3 reference to JTP	LM	RM	RM

SULLIVAN & McLAUGHLIN CO.

74 LAWLEY STREET, BOSTON, MA 02122
PHONE: (617) 474-0500 FAX: (617) 474 0505

CONFIDENTIAL
FOR PROPRIETARY USE ONLY
EXCEPT AS MAY BE OTHERWISE PROVIDED
THIS DRAWING SHALL REMAIN THE PROPERTY OF
Level(3) COMMUNICATIONS
AND SHALL NOT BE REPRODUCED, COPIED, OR USED FOR
ANY PURPOSE WITHOUT SPECIFIC WRITTEN PERMISSION.

DRAWN BY: L. SCOTTO
CHECKED BY: J. DEBARROS
APPROVED BY: H. BERTONI

NATIONAL NETWORK TECHNOLOGIES, LLC
65 BAY STATE DRIVE, BRAINTREE, MA 02184
PHONE: (781) 849-3900 FAX: (781) 849-3993

Level(3) COMMUNICATIONS

LOOP: BOSTON
SEGMENT: A-13
SITE ADDRESS: BOSTON, MA
TITLE: MASS. AVE.
CONTRACT NO: 5980
DRAWING NO: BOS5980P008R1
DATE DRAWN: SEPT2000
SCALE: N.T.S.
PLOT DATE: FEB. 17, 2004 10:00
SHEET: 15
SHEET: 15 OF: 17