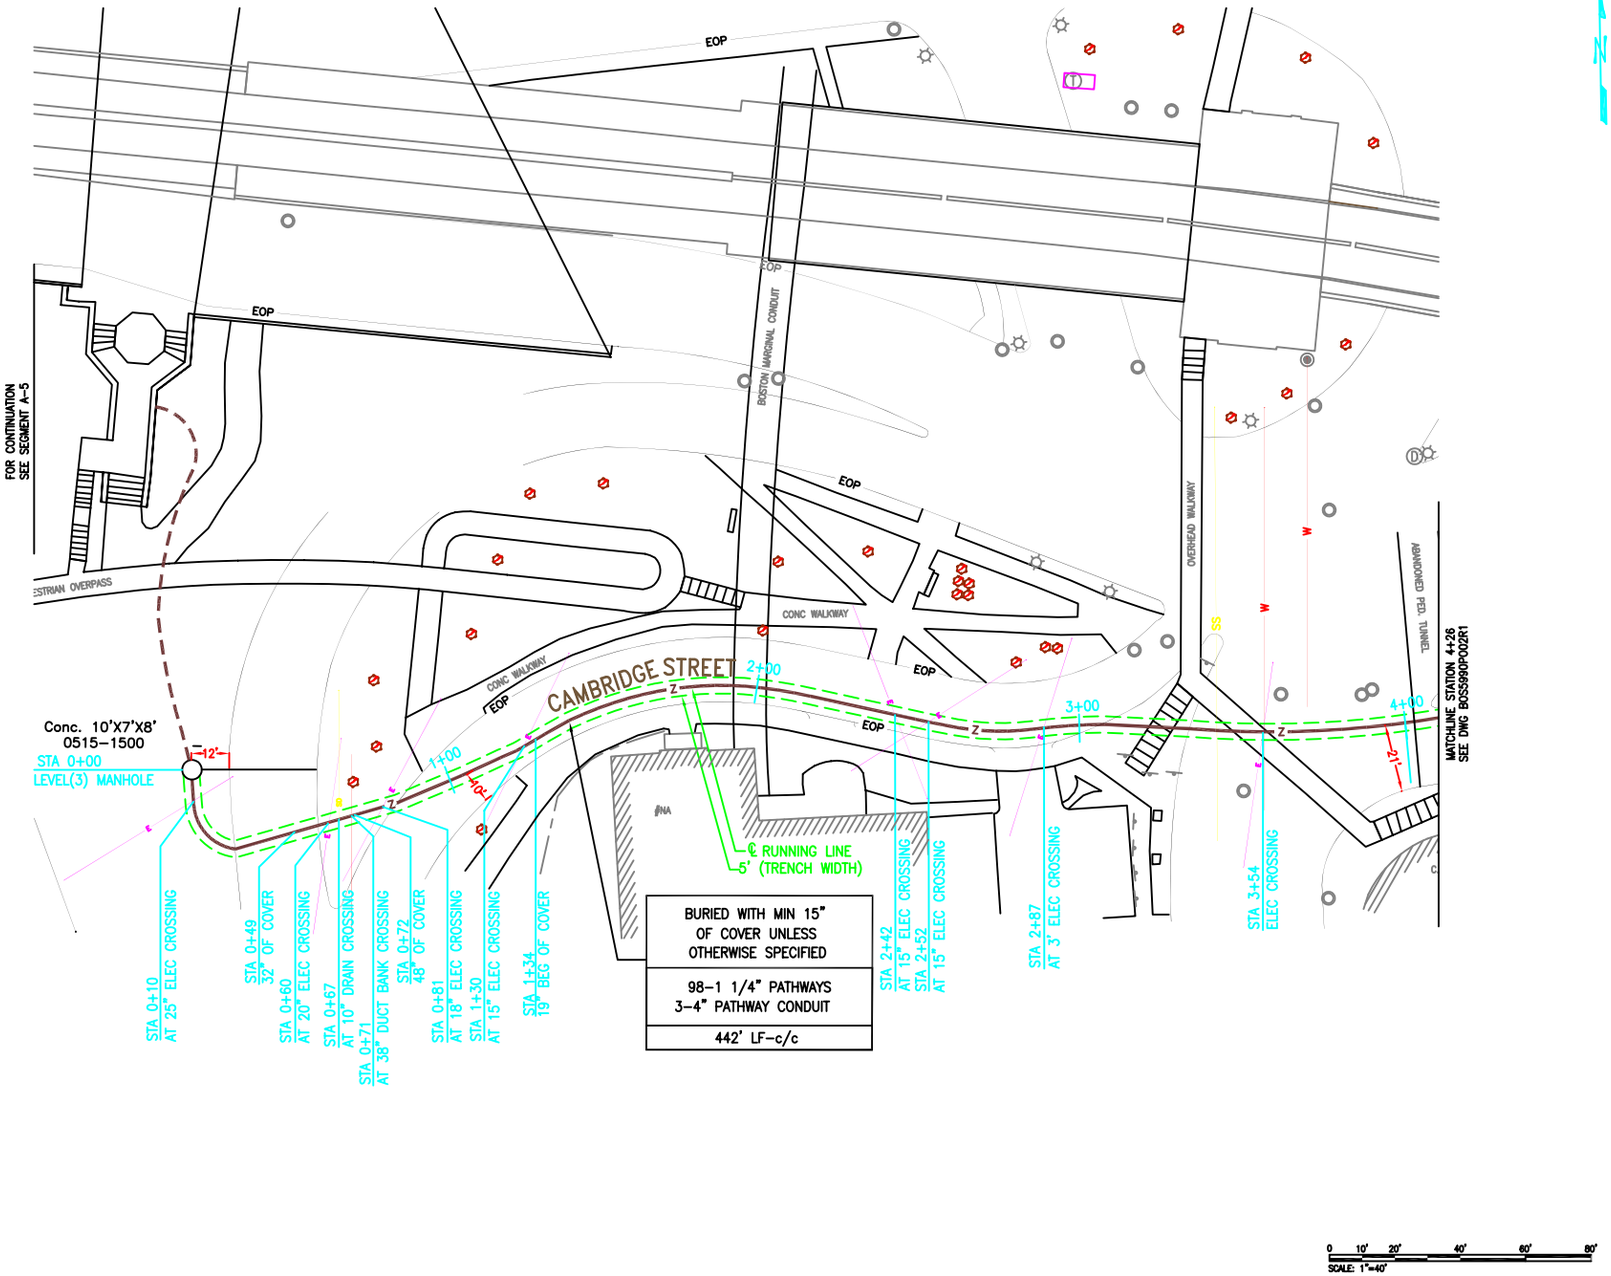

REV	DATE	DESCRIPTION	DRAWN	CHECKED	APPROVED

CONFIDENTIAL
FOR PROPRIETARY USE ONLY
EXCEPT AS MAY BE OTHERWISE PROVIDED
THIS DRAWING SHALL REMAIN THE PROPERTY OF
Level(3) COMMUNICATIONS
AND SHALL NOT BE REPRODUCED, COPIED, OR USED FOR ANY PURPOSE WITHOUT SPECIFIC WRITTEN PERMISSION.

DRAWN BY: MLS
CHECKED BY: ES
APPROVED BY: MS

NATIONAL NETWORK TECHNOLOGIES, LLC
65 BAY STATE DRIVE, BRAINTREE, MA 02184
PHONE: (781) 849-3900 FAX: (781) 849-3993

Level(3) COMMUNICATIONS

LOOP: BOSTON
SEGMENT: A-6
SITE ADDRESS: BOSTON, MA

TITLE: CAMBRIGDE STREET

CONTRACT NO: 5990
DRAWING NO: BOS5990P001R1
DATE DRAWN: 08/25/01
SCALE: 1" = 40'
PLOT DATE: 02/01/02

SHEET: 05
SHEET: 05 OF: 11