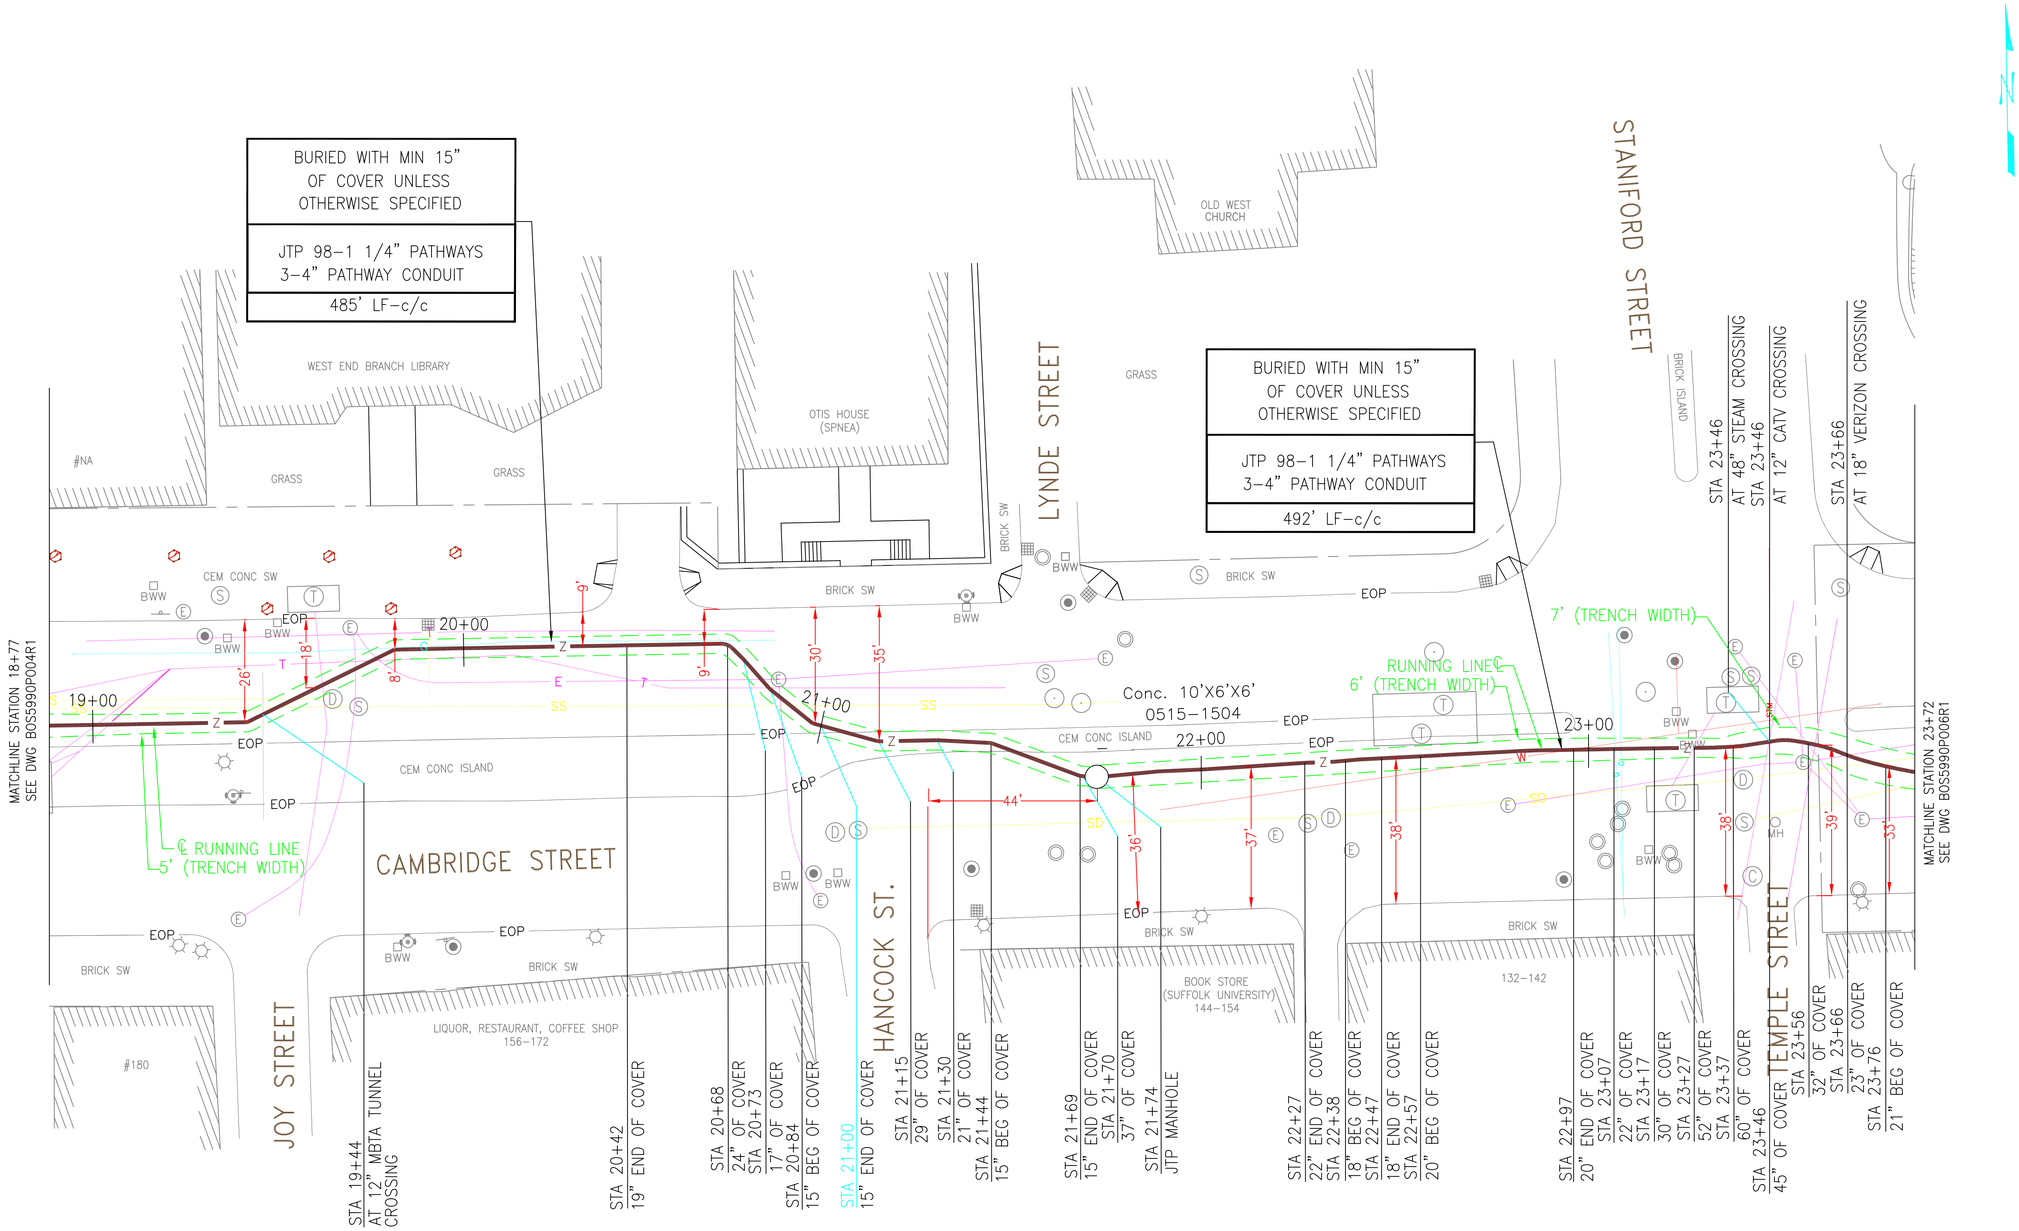

REV	DATE	DESCRIPTION	DESIGNED	CHECKED	APPROVED
1	4/11/03	Changed Level 3 reference to JTP	LM	BW	BW

SULLIVAN & McLAUGHLIN CO.
74 LAWLEY STREET, BOSTON, MA 02122
PHONE: (617) 474-0500 FAX: (617) 474 0505

CONFIDENTIAL
FOR PROPRIETARY USE ONLY
EXCEPT AS MAY BE OTHERWISE PROVIDED
THIS DRAWING SHALL REMAIN THE PROPERTY OF
Level (3) COMMUNICATIONS
AND SHALL NOT BE REPRODUCED, COPIED, OR USED FOR ANY PURPOSE WITHOUT SPECIFIC WRITTEN PERMISSION.

DRAWN BY: MLS

CHECKED BY: ES

APPROVED BY: MS

NATIONAL NETWORK TECHNOLOGIES, LLC

Level (3) SM COMMUNICATIONS

LOOP: BOSTON

SEGMENT: A-6

SITE ADDRESS: BOSTON, MA

TITLE: CAMBRIGDE STREET

CONTRACT NO: 5990

DRAWING NO: BOS5990P005R1

DATE DRAWN: 08/25/01

SCALE: 1" = 40'

PLOT DATE: 04/11/03

SHEET: 09

SHEET: 09 OF: 11