


| REV. | DATE | DESCRIPTION | DESIGNER | CHECKED | APPROVED |
|---|---|---|---|---|---|
| 1 | MAR2001 | AS BUILT | RM | JB | HB |
| 2 | 4/14/03 | Changed Level 3 reference to JTP | LM | BW | BW |


SULLIVAN & McLAUGHLIN CO.
74 LAWLEY STREET, BOSTON, MA 02122
PHONE: (617) 474-0500 FAX: (617) 474 0505

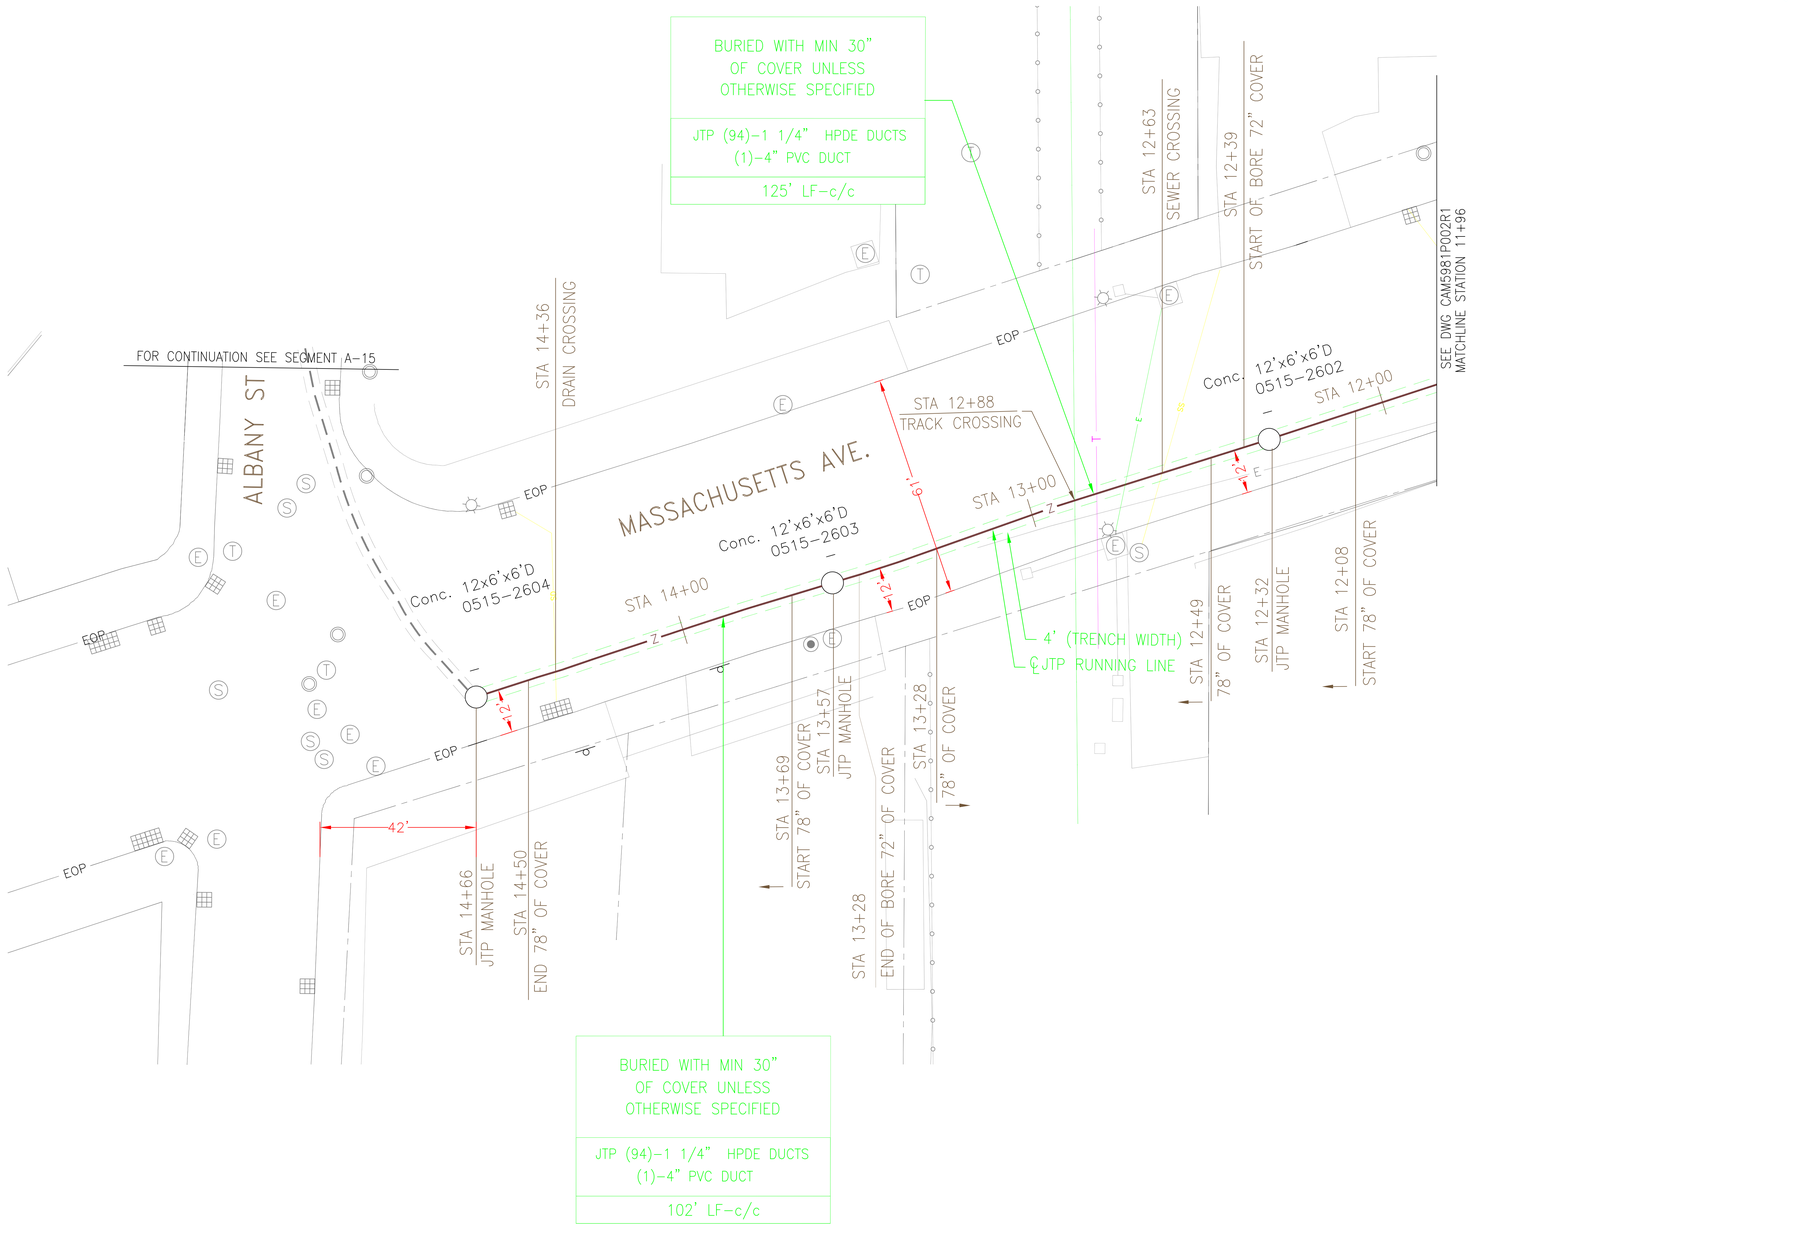

**CONFIDENTIAL**
**FOR PROPRIETARY USE ONLY**
EXCEPT AS MAY BE OTHERWISE PROVIDED
THIS DRAWING SHALL REMAIN THE PROPERTY OF
Level (3) COMMUNICATIONS
AND SHALL NOT BE REPRODUCED, COPIED, OR USED FOR ANY PURPOSE WITHOUT SPECIFIC WRITTEN PERMISSION.


DRAWN BY: R. MEJIA

CHECKED BY: J. DE BARROS

APPROVED BY: H. BERTONI

NATIONAL NETWORK TECHNOLOGIES, LLC

Level (3) COMMUNICATIONS

LOOP: CAMBRIDGE

SEGMENT: A-14

SITE ADDRESS: CAMBRIDGE, MA

TITLE: ALBANY ST AND MASS AVE

CONTRACT NO: 5981

DRAWING NO: CAM5981P001R1

DATE DRAWN: MAY2000

SCALE: 1" = 40'

PLOT DATE: 4/14/03

SHEET: 05

SHEET: 5 OF: 8