


SOMERVILLE

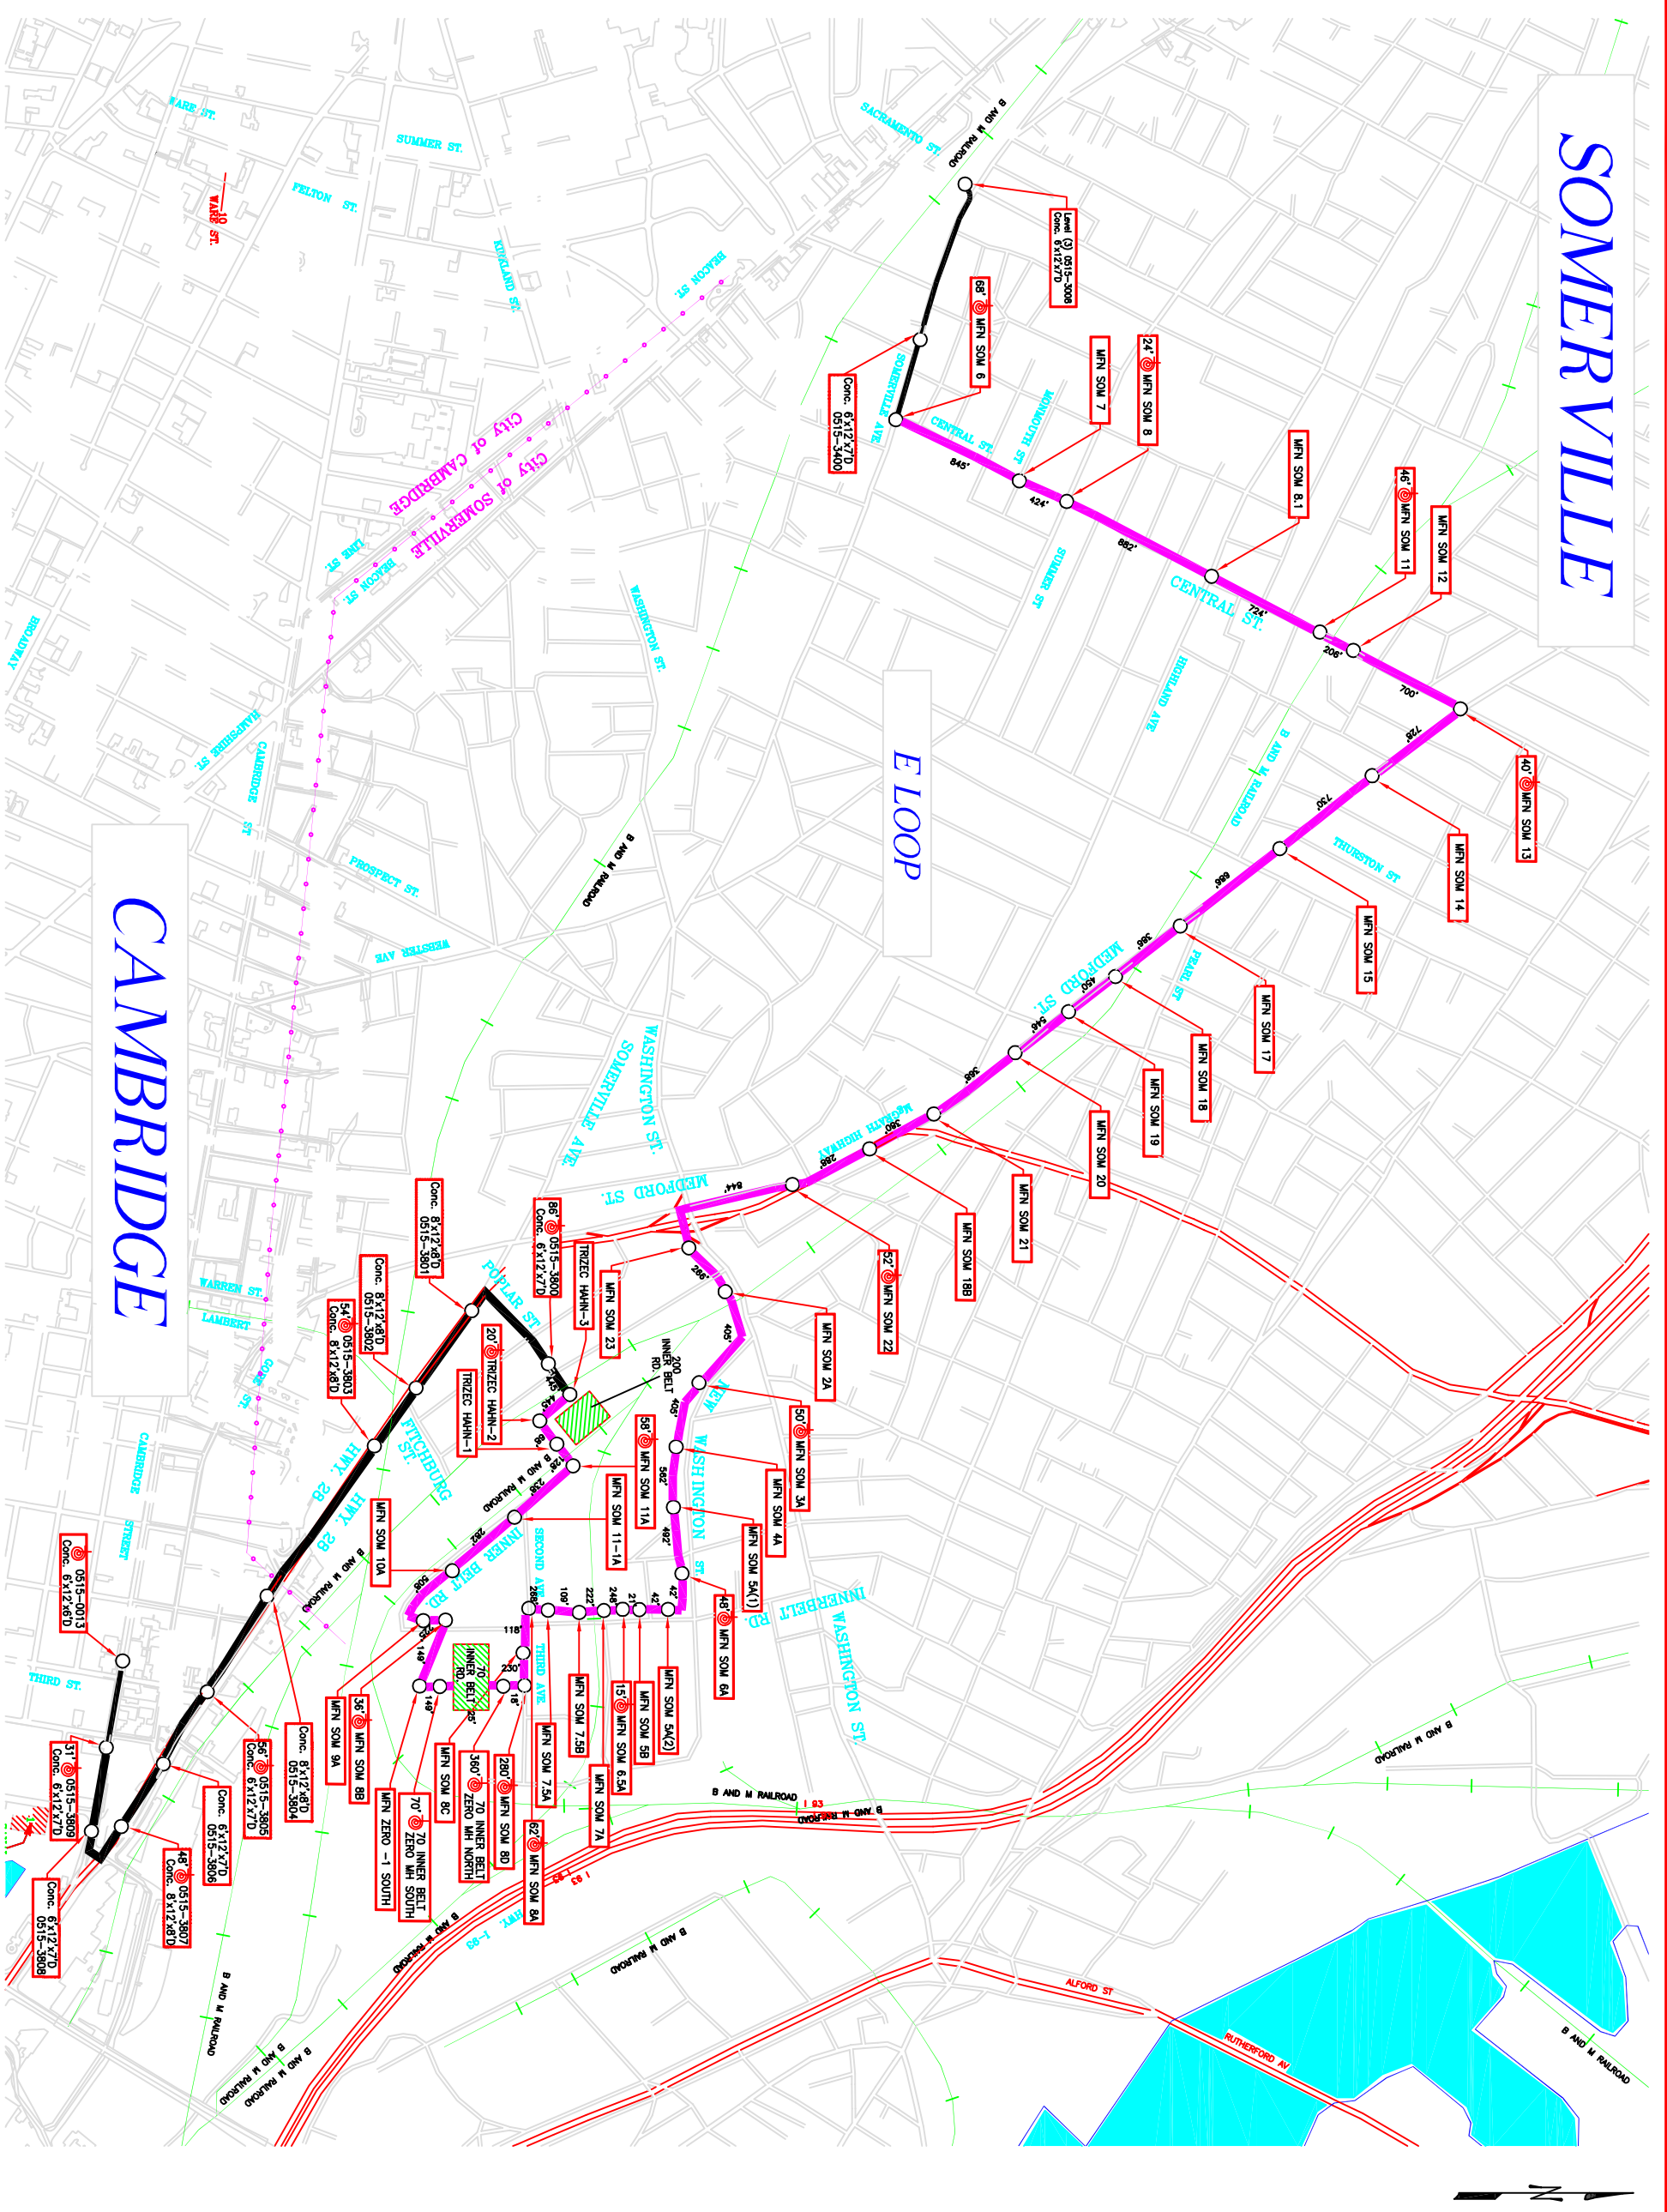

CAMBRIDGE

REV	DATE	DESCRIPTION	DESIGN	DATE



SULLIVAN & McLAUGHLIN CO.
 74 LAWLEY STREET, BOSTON, MA 02122
 PHONE: (617) 474-0500 FAX: (617) 474 0505

LEGEND

- MFN CONDUIT & CABLE INSTALLED █
- LEVEL (3) CONDUIT & CABLE INSTALLED █
- MANHOLE = ○
- SLACK LOOP = ⊕

DRAWN BY: R. MEJIA
 CHECKED BY: M. SARACENO
 APPROVED BY: K. EGAN

NATIONAL NETWORK TECHNOLOGIES, LLC
 65 BAY STATE DRIVE, BRAintree, MA 02184
 PHONE: (781) 849-3900 FAX: (781) 849-3993

Level (3)SM

COMMUNICATIONS

LOOP: E LOOP
 SEGMENT:
 SITE ADDRESS: SOMERVILLE, MA

OVERALL MAP

TITLE:
 CONTRACT NO: 8728
 DRAWING NO: som_Eloop.dwg
 DATE DRAWN: FEB2002
 SCALE: N.T.S.
 PLOT DATE: FEBRUARY 22, 2002